

WESTFORD TOWN HALL ADDITION & RENOVATIONS






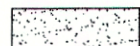
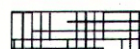
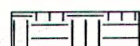

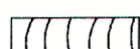
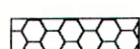

55 MAIN STREET


DATE: SEPTEMBER 2, 2009

PARTIAL LIST OF ABBREVIATIONS:

@	AT
#	NUMBER
AFF	ABOVE FINISHED FLOOR
ALUM	ALUMINUM
BBT	BIOBASED TILE
BD	BOARD
BET	BETWEEN
BLDG	BUILDING
BOT	BOTTOM
CAB	CABINET
CLG	CEILING
COL	COLUMN
CONC	CONCRETE
CONT	CONTINUOUS
CPT	CARPET
CT	CERAMIC TILE
DEMO	DEMOLISH
DET	DETAIL
DWG	DRAWING
DWR	DRAWER
EA	EACH
EL	ELEVATION
ELEC	ELECTRICAL
EQ	EQUAL
EXISTG	EXISTING
FL, FLR	FLOOR
GWB	GYPSUM WALLBOARD
HGT	HEIGHT
HM	HOLLOW METAL
JT	JOINT
LIN	LINOLEUM
LEV	LEVEL
MATL	MATERIAL
MAX	MAXIMUM
MECH	MECHANICAL
MIN	MINIMUM
NIC	NOT IN CONTRACT
O.C.	ON CENTER
OPENG	OPENING
PLAM	PLASTIC LAMINATE
PT	PRESSURE TREATED
PLYWD	PLYWOOD
REQ'D	REQUIRED
RM	ROOM
RO	ROUGH OPENING
RUB	RUBBER
SIM	SIMILAR
STL	STEEL
TYP	TYPICAL
UNO	UNLESS NOTED OTHERWISE
VEN PLAS, VP	VENEER PLASTER
VIF	VERIFY IN FIELD
VIN	VINYL
WD	WOOD

MATERIALS:

	CMU
	CONC
	STEEL
	RIGID INSUL
	PLYWD
	VP/GWB
	PARTICLE BD
	EARTH
	GRAVEL/STONE
	WOOD
	PVC
	BATT INSUL

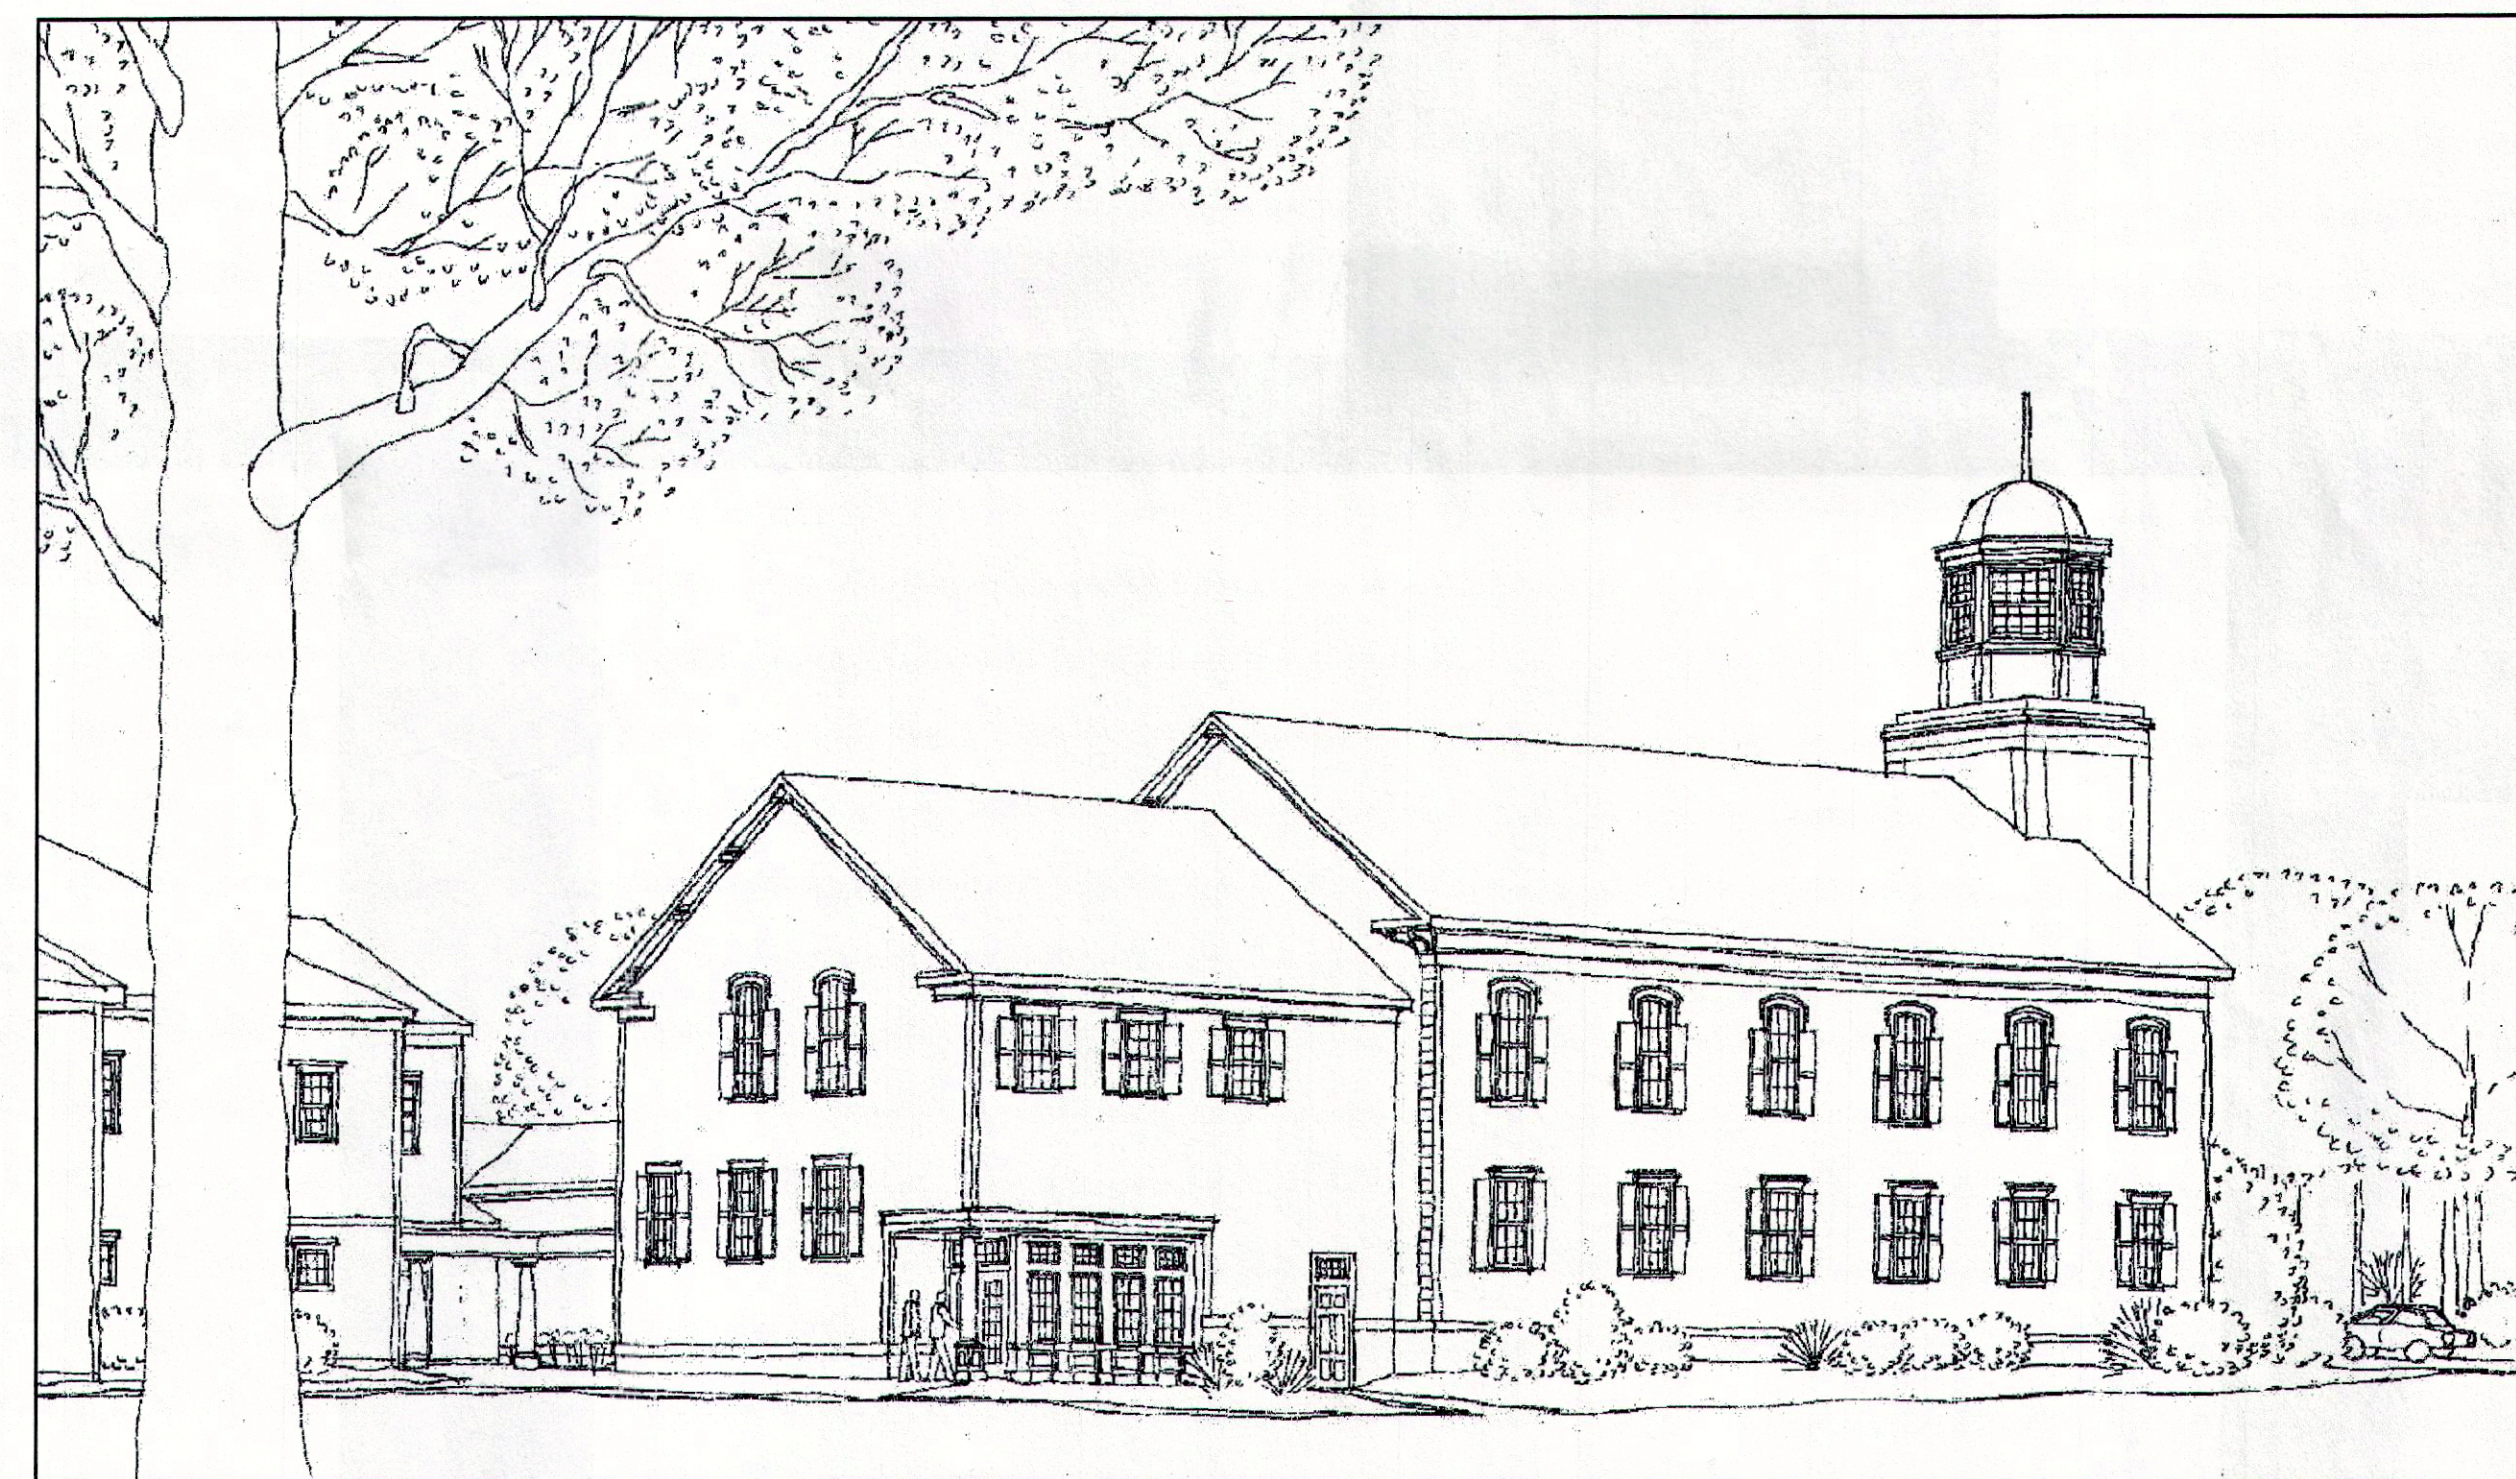

ARCHITECT:
KANG ASSOCIATES, INC.
339 BOSTON POST ROAD
SUDBURY, MA 01776

CIVIL ENGINEER/SURVEYOR:
LANDTECH CONSULTANTS.
484 GROTON ROAD
WESTFORD, MA 01886

STRUCTURAL ENGINEER:
FOLEY, BUHL, ROBERTS & ASSOCIATES, INC.
2150 WASHINGTON STREET
NEWTON, MA 02462

MECHANICAL ENGINEER:
SEAMAN ENGINEERING CORPORATION
30 FAITH AVENUE
AUBURN, MA 01501

ELECTRICAL ENGINEER:
NANGLE ENGINEERING, INC.
32 PRINCE STREET
DANVERS, MA 01923

LIST OF DRAWINGS

COVER SHEET

TS	SITE PLAN TITLE SHEET
EX-1	EXISTING CONDITIONS PLAN
GD-1	GRADING AND DRAINAGE PLAN
SU-1	UTILITIES, LAYOUT AND MATERIALS PLAN
DS-1	DETAILS AND SECTIONS
10F3	ALT#2 PARKING PLAN
20F3	ALT#2 CONSTRUCTION & EROSION CONTROL PLAN
30F3	ALT#2 CONSTRUCTION & EROSION CONTROL DETAILS

D1	DEMOLITION PLANS
D2	DEMOLITION ELEVATIONS
A1	FIRST, SECOND, & BALCONY FLOOR PLANS
A2	BASEMENT, ROOF, & ATTIC PLANS
A3	BUILDING ELEVATIONS
A4	BUILDING SECTIONS & EXTERIOR DETAILS
A5	ENLARGED PLANS & SECTIONS
A6	WALLS SECTIONS
A7	ENTRY ELEVATIONS DETAILS
A8	WINDOW TYPES & DETAILS
A9	INTERIOR ELEVATIONS
A10	MILLWORK ELEVATIONS & DETAILS
A11	INTERIOR DETAILS & PARTITION TYPES
A12	STAIR DETAILS
A13	SCHEDULES & DOOR DETAILS
A14	REFLECTED CEILING PLANS
S0.1	GENERAL NOTES
S0.2	TYPICAL DETAILS
S1	FLOOR PLANS
S2	FLOOR & ROOF PLANS
S3	SECTIONS
S4	SECTIONS
S5	SECTIONS
S6	SECTIONS
S7	SECTIONS






FP1	BASEMENT & ATTIC FIRE PROTECTION PLANS
FP2	FIRST & SECOND FLOOR FIRE PROTECTION PLANS
FP3	FIRE PROTECTION NOTES, DETAILS & LEGEND

DP1	PLUMBING DEMOLITION PLANS
P1	BASEMENT, ROOF AND ATTIC PLUMBING PLANS
P2	FIRST AND SECOND FLOOR PLUMBING PLANS
P3	PLUMBING NOTES, DETAILS, LEGEND, & SCHEDULES

DH1	HVAC DEMOLITION PLANS
H1	BASEMENT FLOOR HVAC PLAN
H2	FIRST FLOOR HVAC PLAN
H3	SECOND FLOOR HVAC PLAN
H4	ATTIC FLOOR HVAC PLAN
H5	HVAC DETAILS
H6	HVAC CONTROLS
H7	HVAC SCHEDULES

E1	LEGEND & GENERAL NOTES
E2	ELECTRICAL DEMOLITION PLANS
E3	ELECTRICAL PROPOSED LIGHTING PLANS I
E4	ELECTRICAL PROPOSED LIGHTING PLANS II
E5	ELECTRICAL PROPOSED POWER PLANS I
E6	ELECTRICAL PROPOSED POWER PLANS II
E7	SCHEDULES & ONE-LINE DIAGRAMS
E8	ELECTRICAL PROPOSED FIRE ALARM PLANS

SYMBOLS:

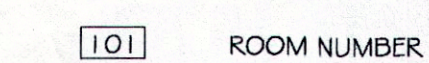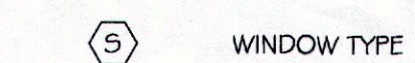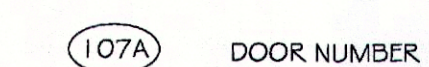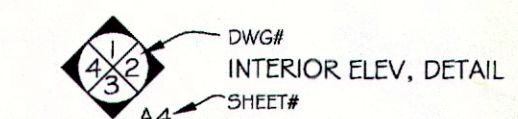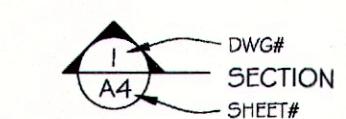

As-BUILT

MAY 9, 2011